




NOTES:
 1. GREEN BOREHOLES WITH RED TEXT ARE COMPLETE.
 2. ORANGE TEXT AND DATES ARE A TWO-WEEK PROJECTION.

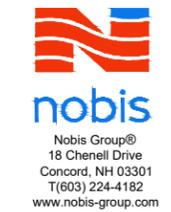


**NOBIS
 PROGRESS
 MARKUP AS OF
 JUNE 30, 2021**

ISSUED FOR
 CONSTRUCTION

ELIZABETH MINE
 SUPERFUND SITE

ADIT CLOSURE
 IMPLEMENTATION
 WORK PLAN

SOUTH STRAFFORD,
 VERMONT

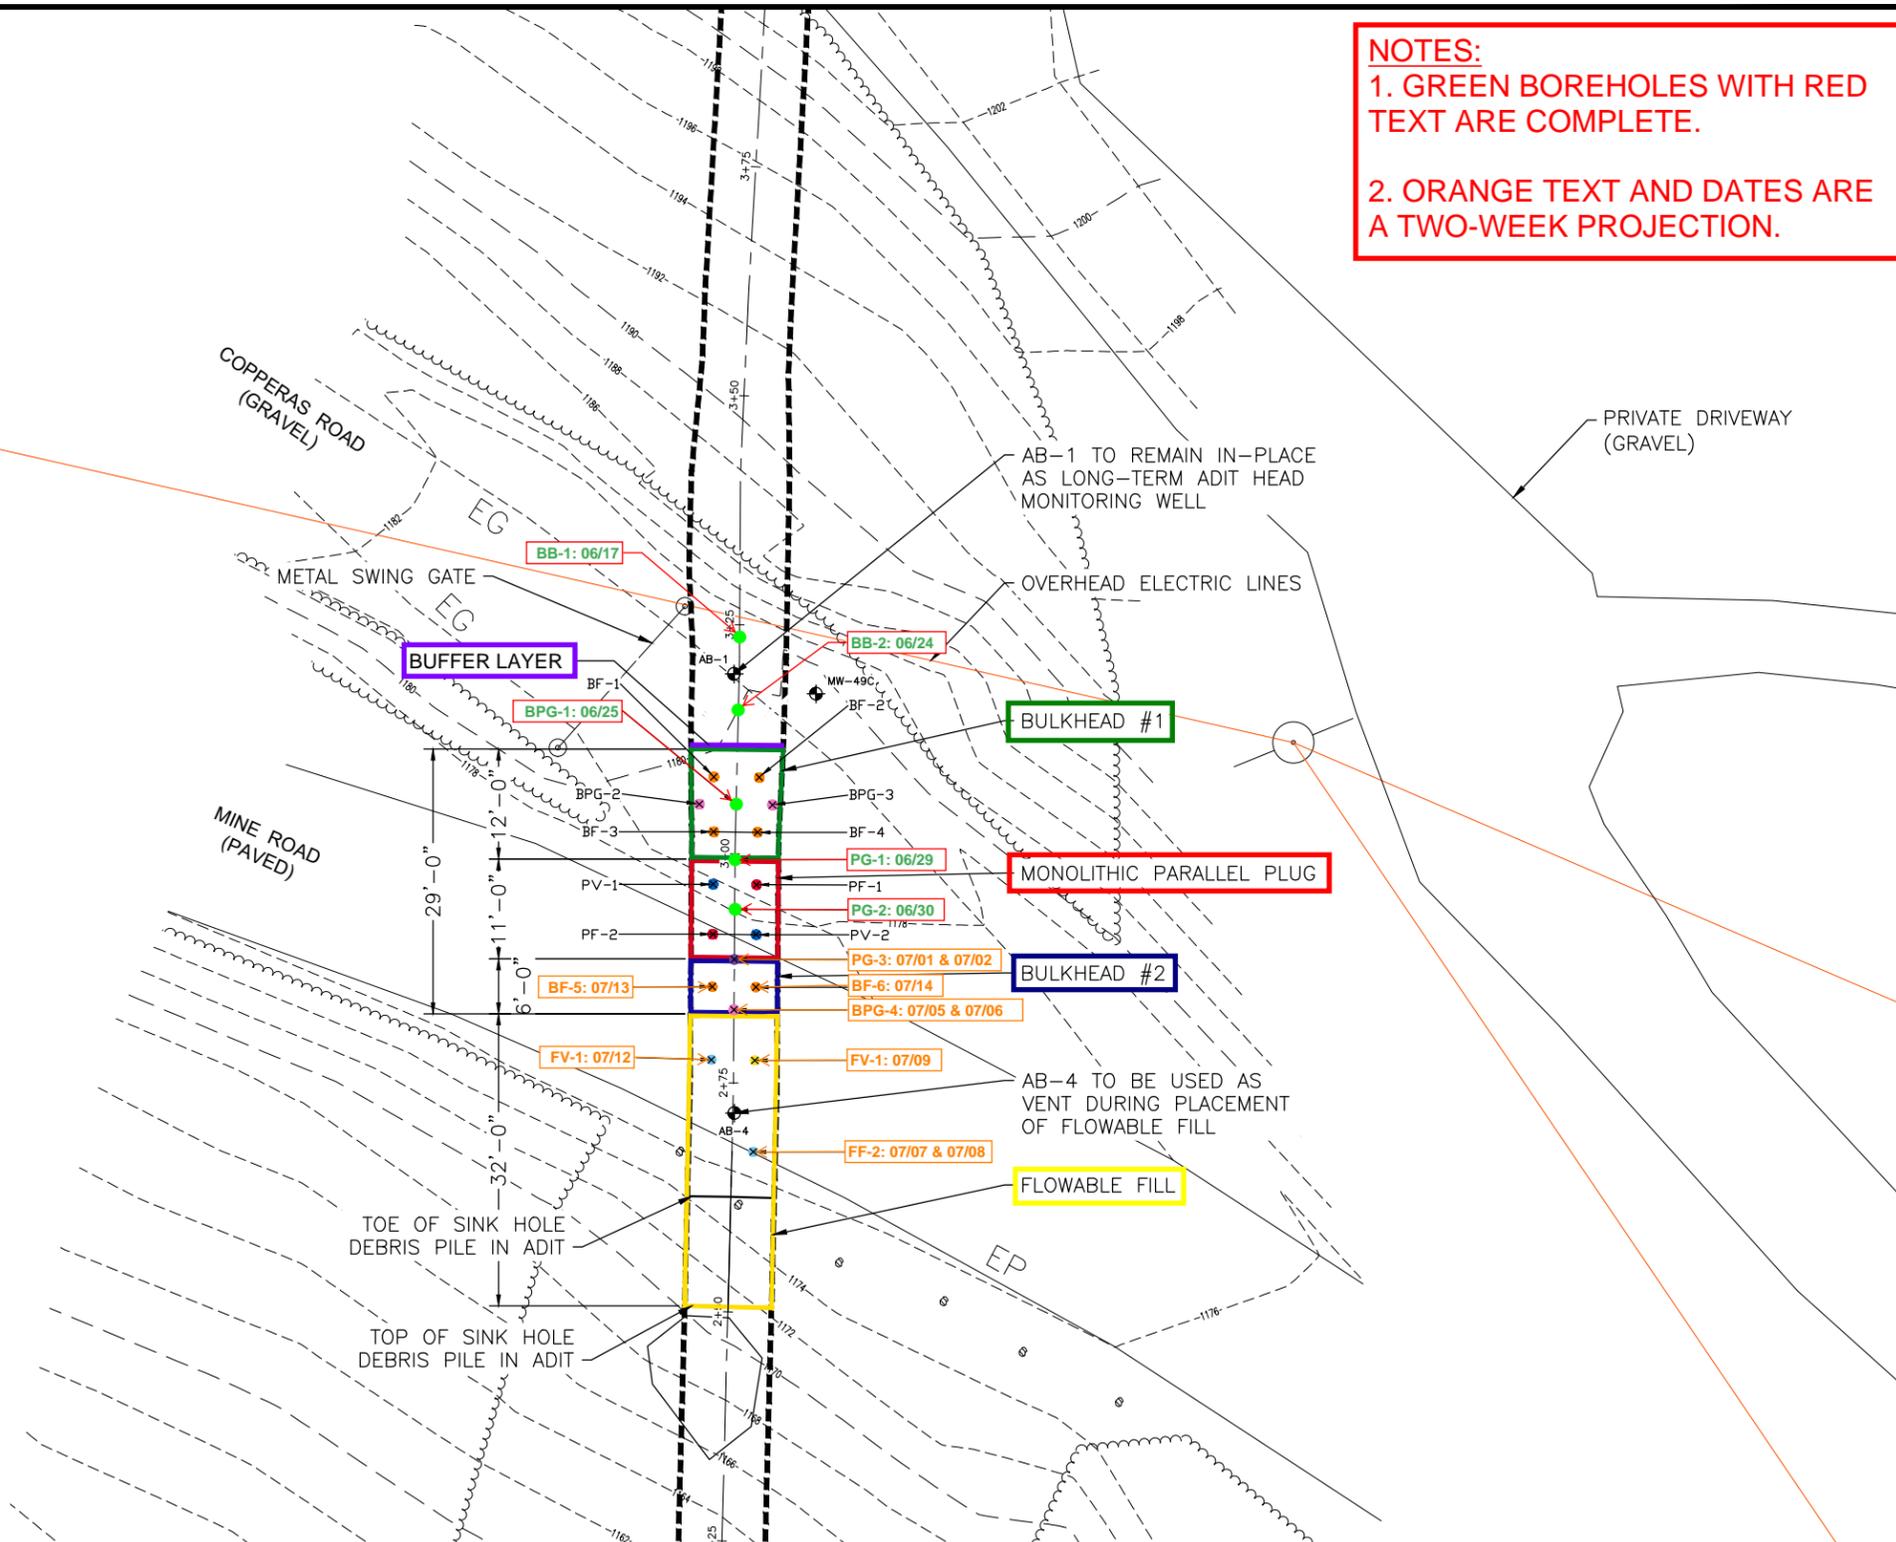

NOTES:
 1. ADIT ALIGNMENT IS BASED ON THE HISTORICAL PROFILE PLAN, PREPARED FOR THE VERMONT COPPER CO. BY WALKER & GALLISON OF MONTPELIER AND BARRE, VERMONT, DATED OCTOBER 1907, AND SONAR DATA OBTAINED BY HAGER GEOSCIENCE INC. IN JUNE 2020.
 2. TOPOGRAPHY AND PHYSICAL FEATURES BASED ON FIELD SURVEY CONDUCTED BY DOUCET SURVEY ON JANUARY 8, 9 & 10 2020.

LEGEND:

	MAJOR CONTOUR
	MINOR CONTOUR
	EXISTING TREELINE
	APPROXIMATE LOCATION OF 1898 ADIT EXTENTS
	PROFILE ALIGNMENT

- BUFFER BOREHOLE (BB-#)
- PLUG GROUT BOREHOLE (PG-#)
- PLUG FILL BOREHOLE (PF-#)
- PLUG VENT BOREHOLE (PV-#)
- BULKHEAD PRESSURE GROUT BOREHOLE (BPG-#)
- BULKHEAD FILL BOREHOLE (BF-#)
- FLOWABLE FILL FILL BOREHOLE (FF-#)
- FLOWABLE FILL VENT BOREHOLE (FV-#)
- EXISTING MONITORING WELL

NO.	DATE	DESCRIPTION
REVISIONS		

DATE:	APRIL 23, 2021
NOBIS PROJECT NO.:	94506.00
DRAWN BY:	NZ
CHECKED BY:	CA
CAD DRAWING FILE:	94501-ADIT-CLOSURE-IMP-OPT.dwg
SHEET TITLE	

**1898 ADIT AND
 BOREHOLE
 LAYOUT**

**FIGURE
 6-7**